


First Level
Existing Floor Plan

Scale: 1/4"=1'-0"

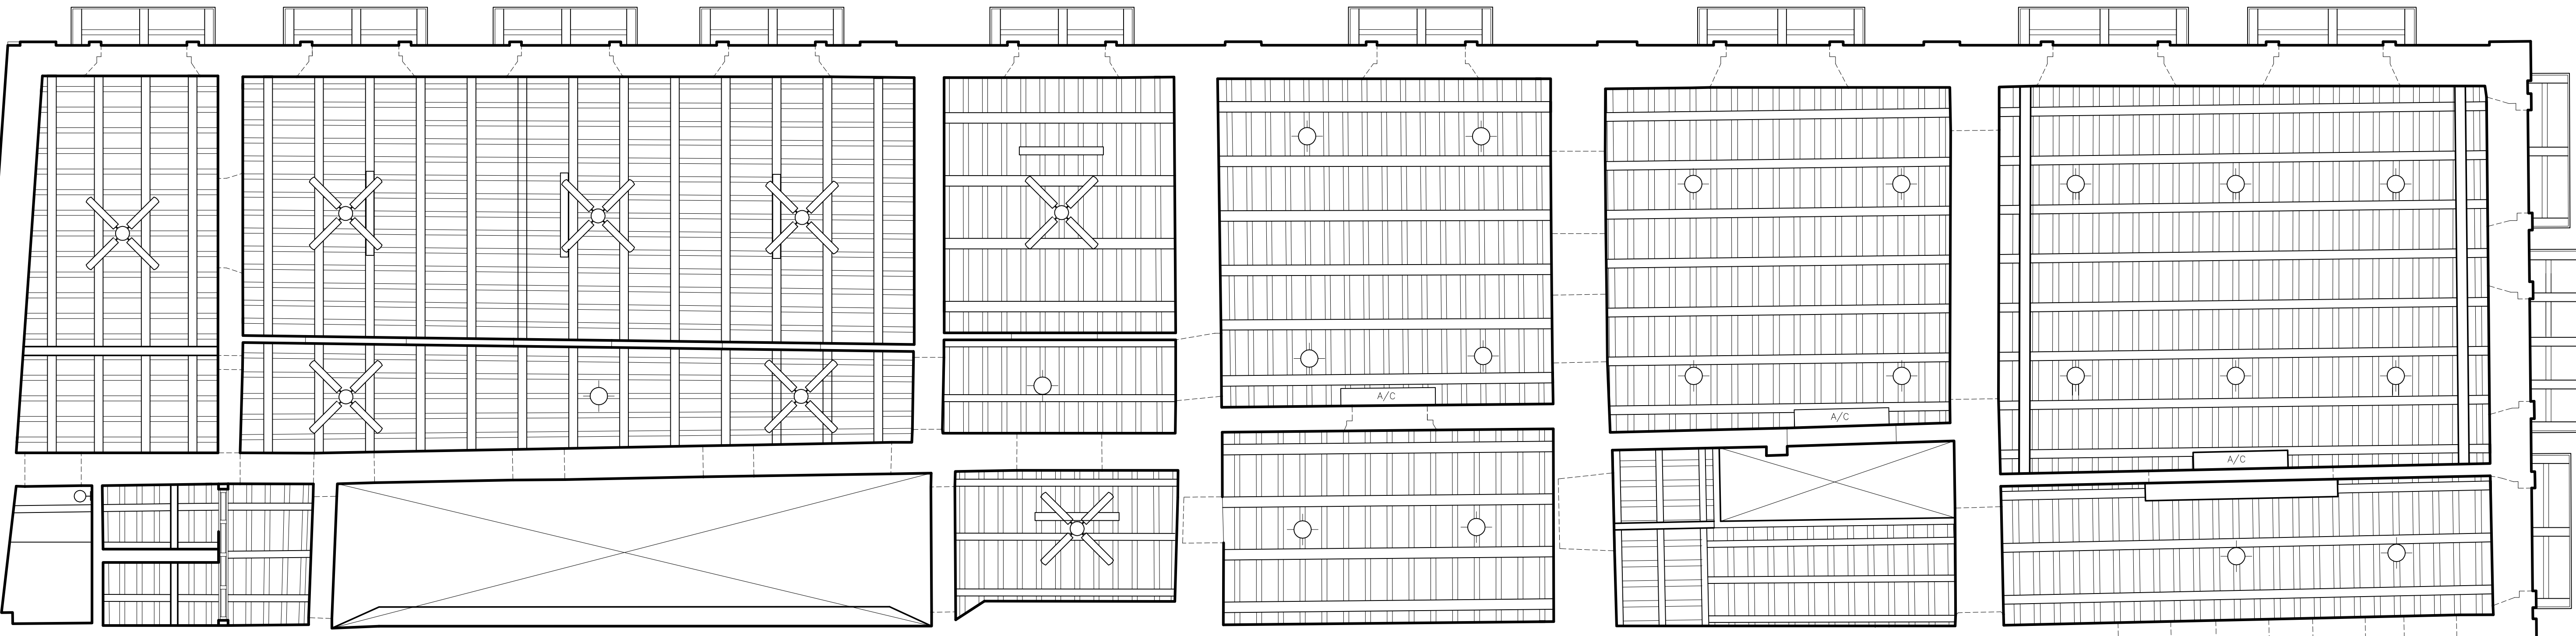

First Level
Reflected Ceiling

Scale: 1/4"=1'-0"

OWNER:
Cherif Medawar

CONSULTANTS
Arq. Radomés Lugo Eschenwald
(787) 594-2873 / rlo@eschenwald.com

PROJECT:
#200 Del Cristo St., Old San Juan
As Built Drawings
San Juan, P.R.


REVISIONS
NO. DATE
1
2
3
4
5

NOTES / PERMITS

DATE: October 24, 2015


Roof Plan
(As Built)

HOJA:
AB-1

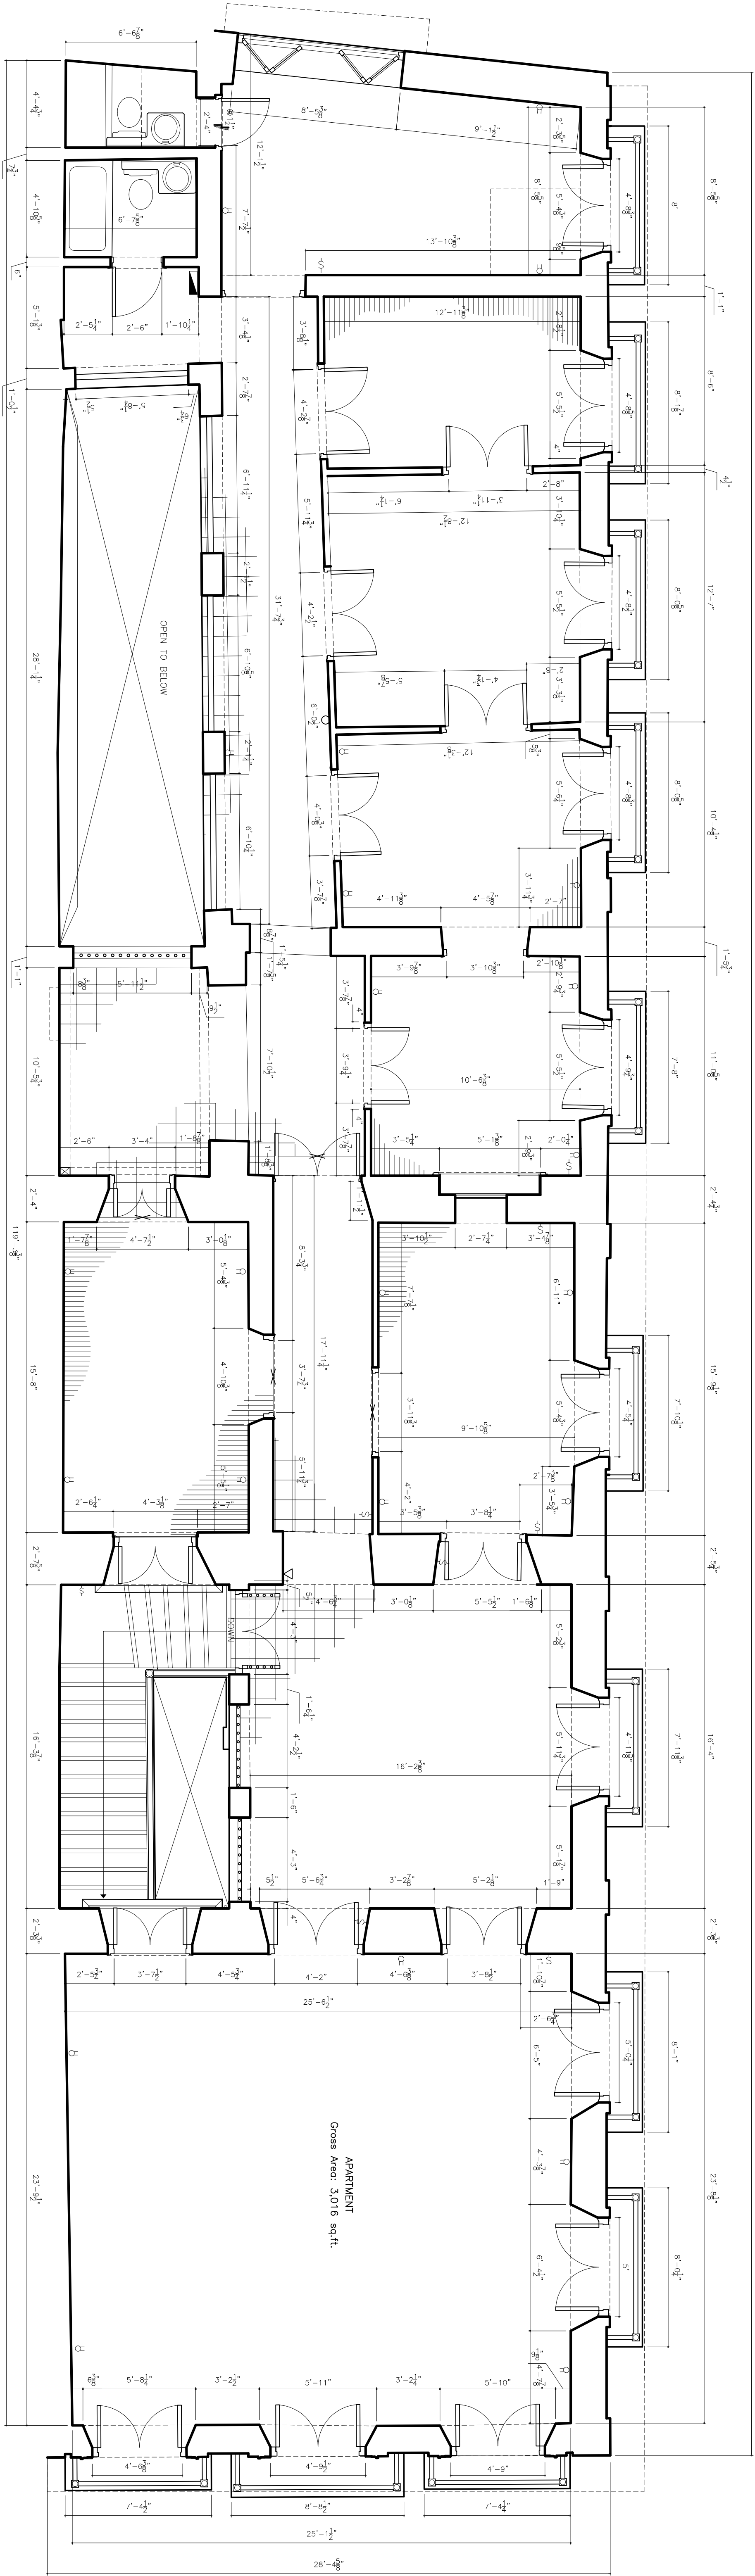

Second Level
Existing Floor Plan

Scale: 1/4"=1'-0"

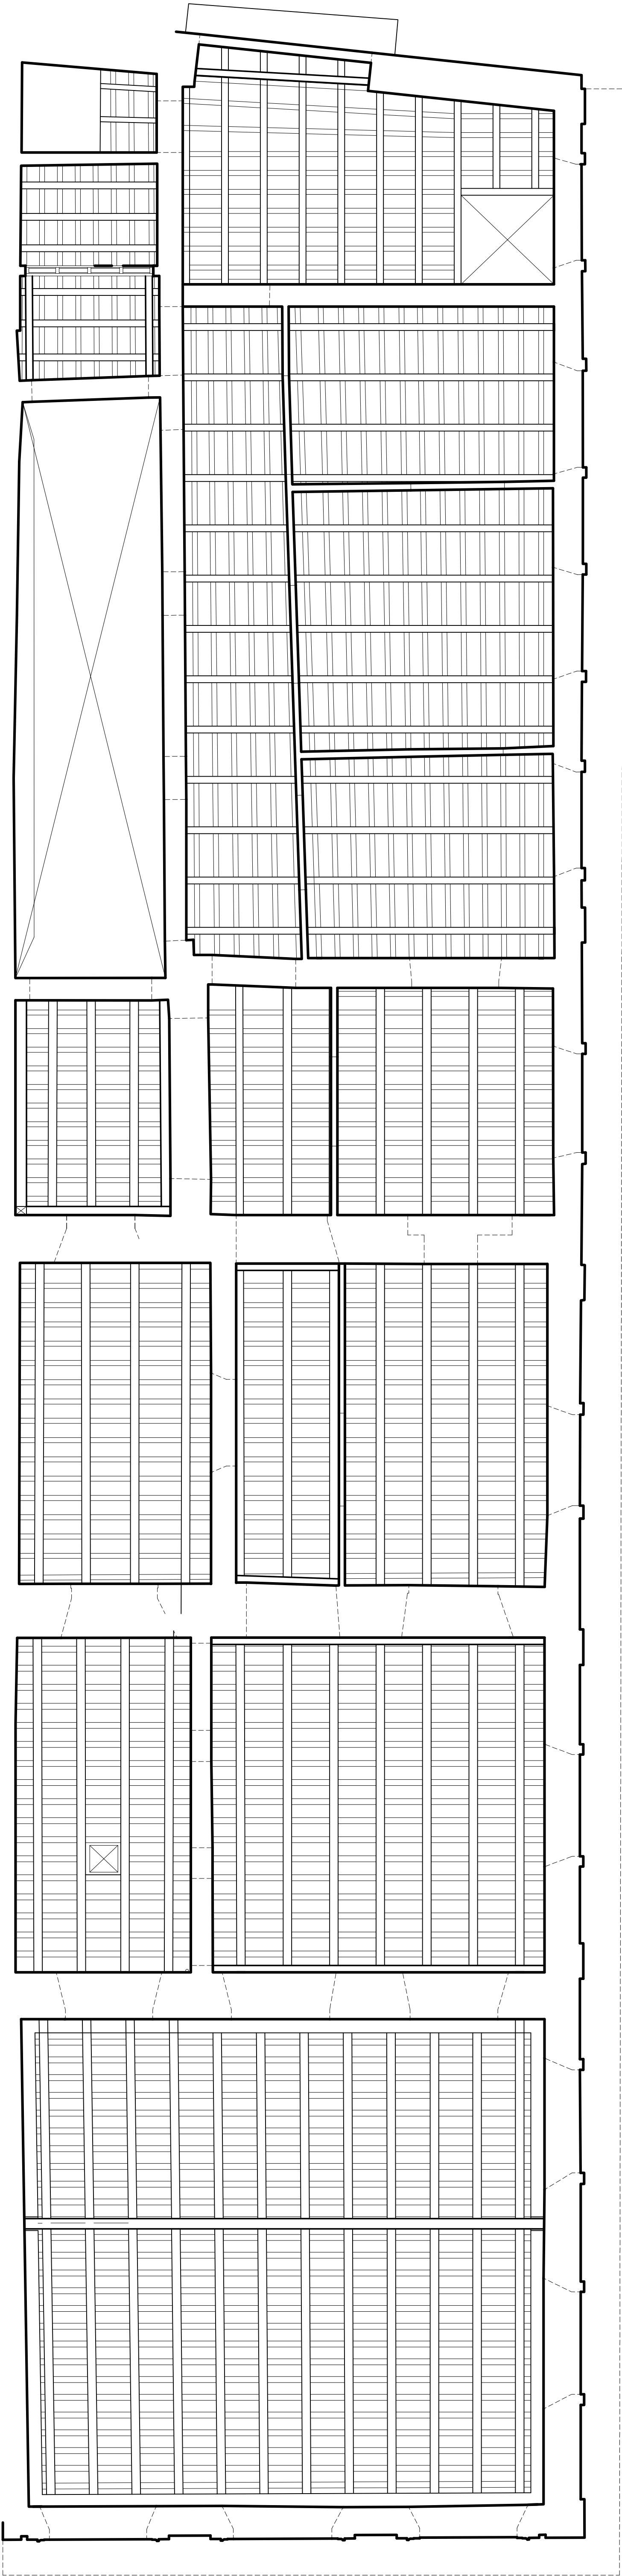

Second Level
Reflected Ceiling

Scale: 1/4"=1'-0"

OWNER:

Cheif Medowar

CONSULTANTS

Arch. Rodenas Lugo Screenfield
(info@rodslugo.com | 787.462.6666)

PROJECT:

#200 Del Cristo St., Old San Juan
As Built Drawings

San Juan, P.R.

REVISIONS

NO.	DATE
1	
2	
3	
4	
5	


NOTES / PERMITS

DATE: October 24, 2015

Roof Plan
(As Built)


HOTAS:

AB-2

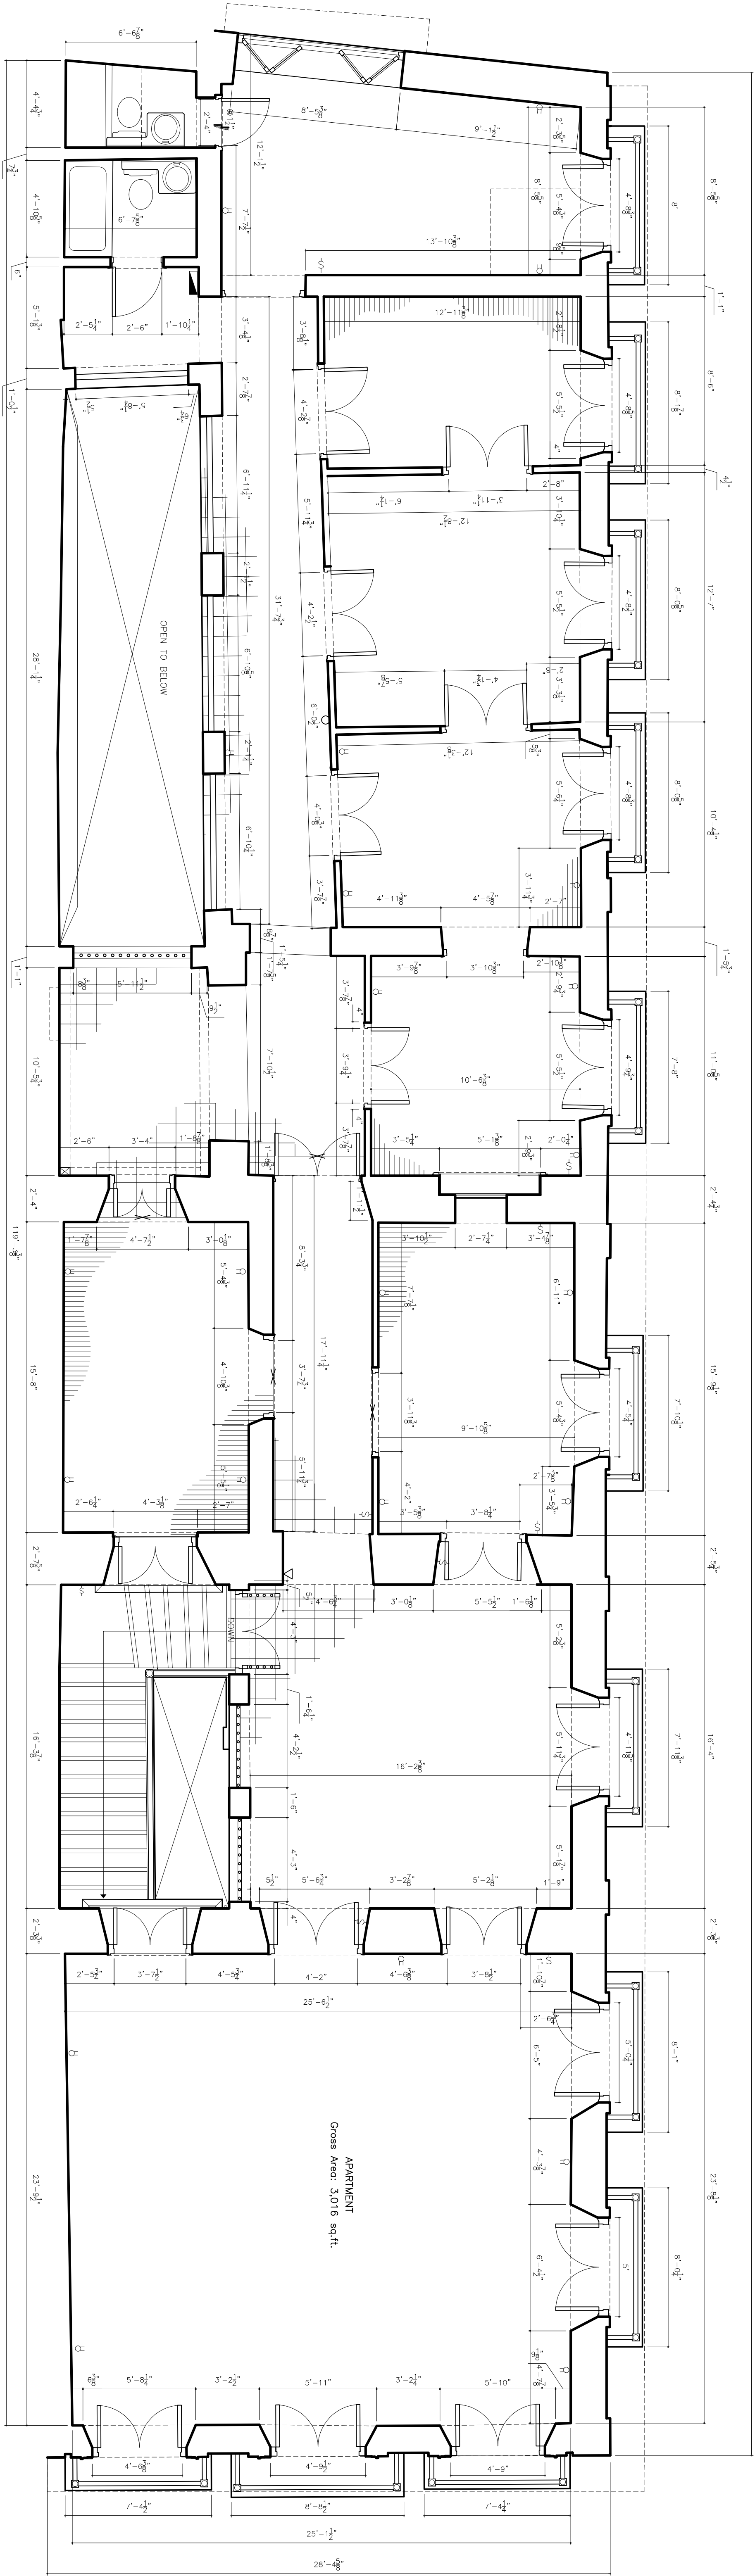

Second Level
Existing Floor Plan

Scale: 1/4"=1'-0"

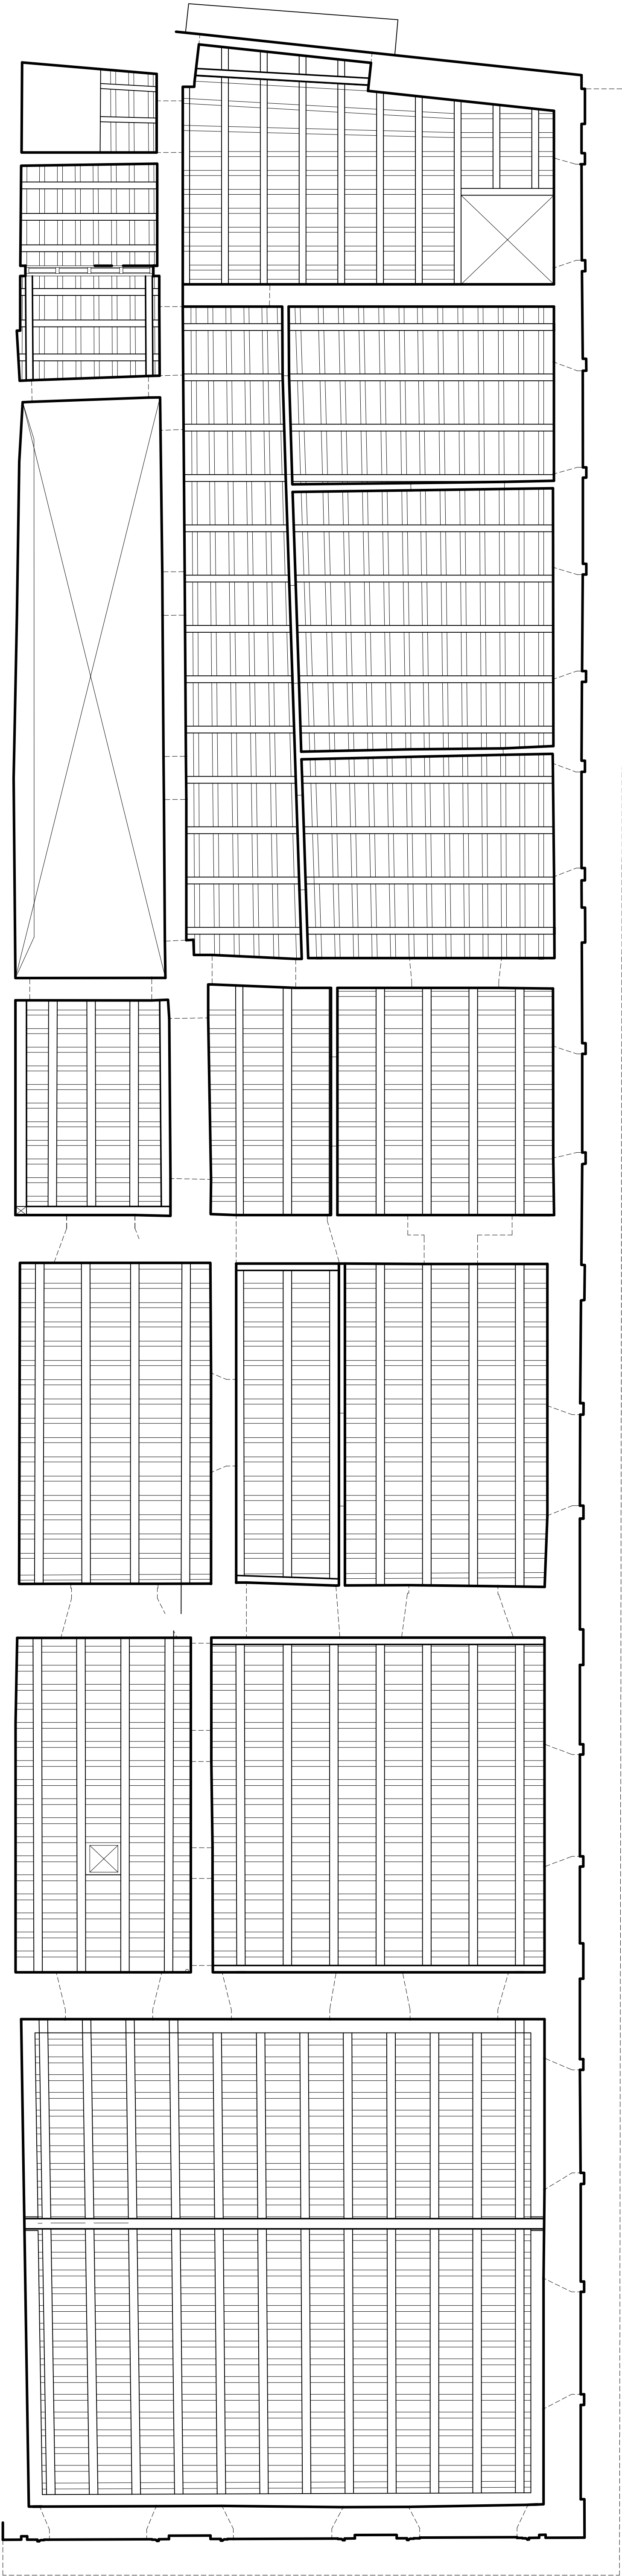

Second Level
Reflected Ceiling

Scale: 1/4"=1'-0"

OWNER:

Cheif Medowar

CONSULTANTS

Architect: Lugo Screenfield
(707) 360-7777 / lugo@lugo-screenfield.com

PROJECT:

#200 Del Cristo St., Old San Juan
As Built Drawings
San Juan, P.R.

REVISIONS

NO.	DATE
1	
2	
3	
4	
5	


NOTES / PERMITS

DATE: October 24, 2015

Roof Plan
(As Built)



HOTAS:

AB-2

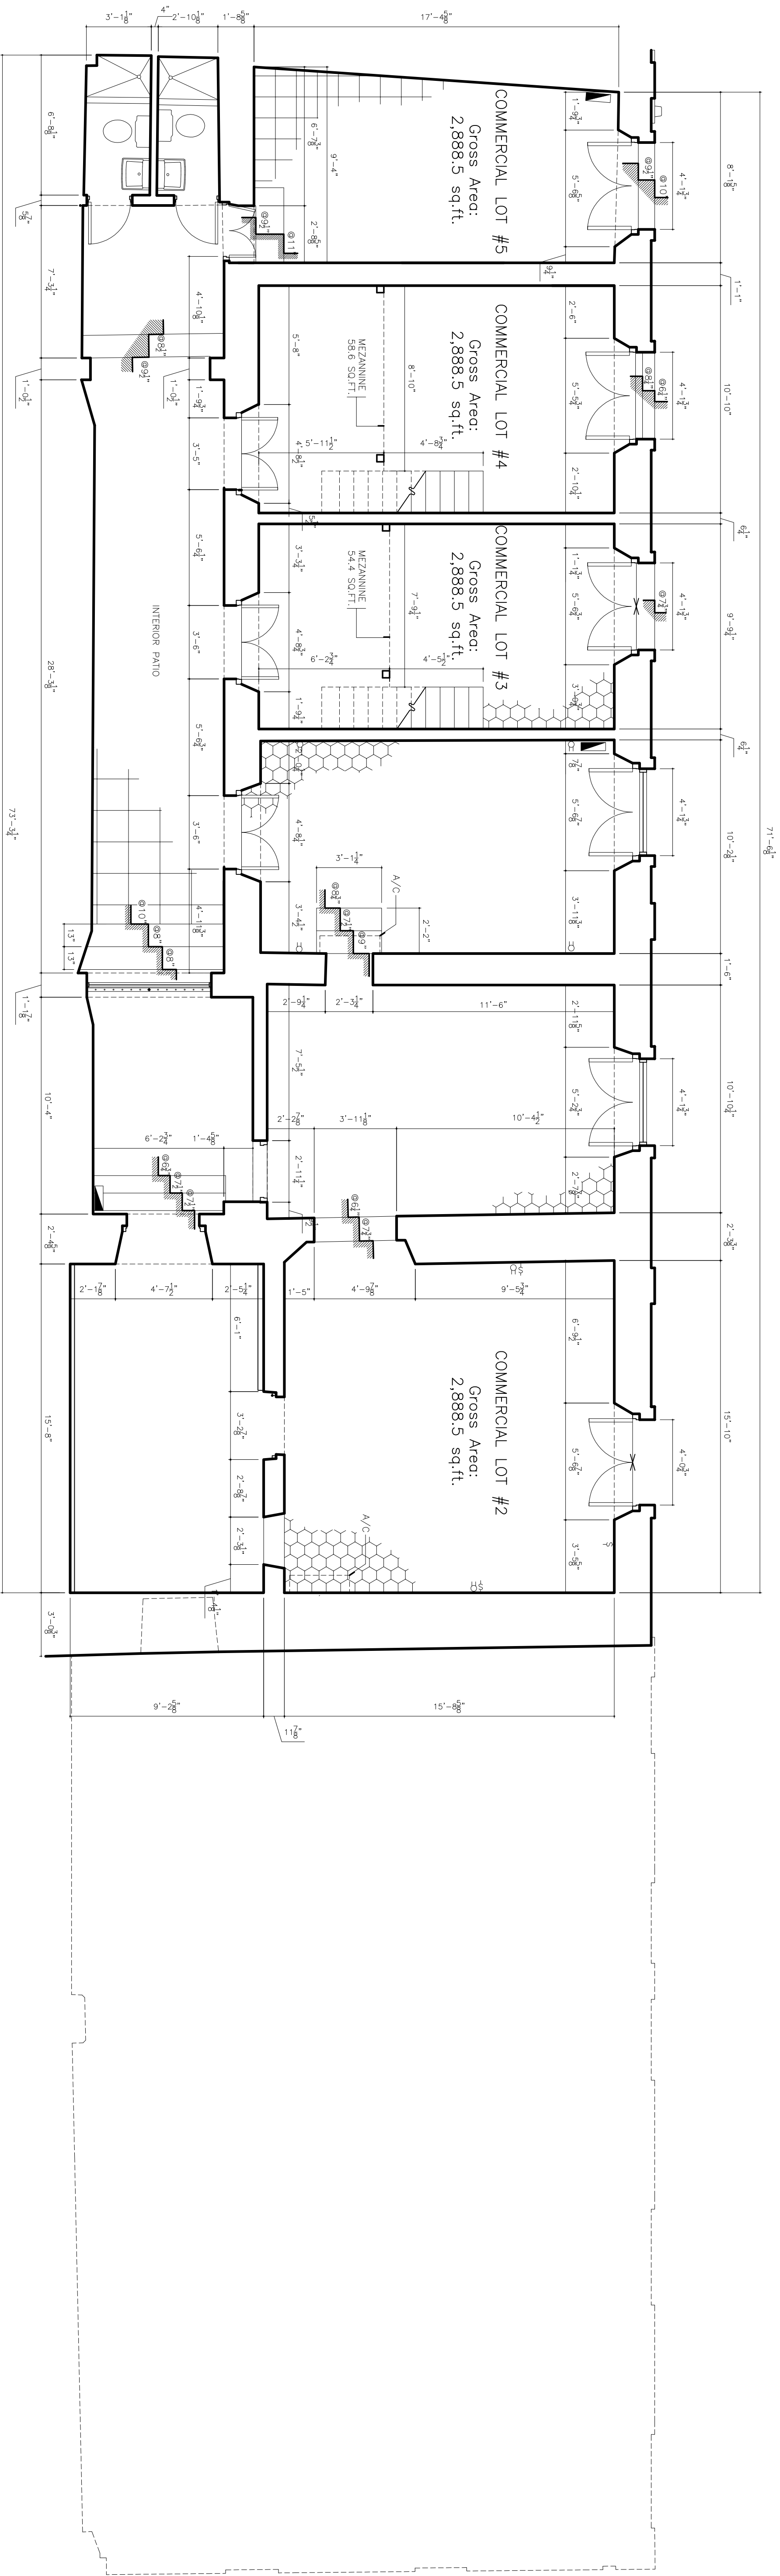

Lower Level Commercial Spaces Existing Floor Plan

Scale: 1/4"=1'-0"

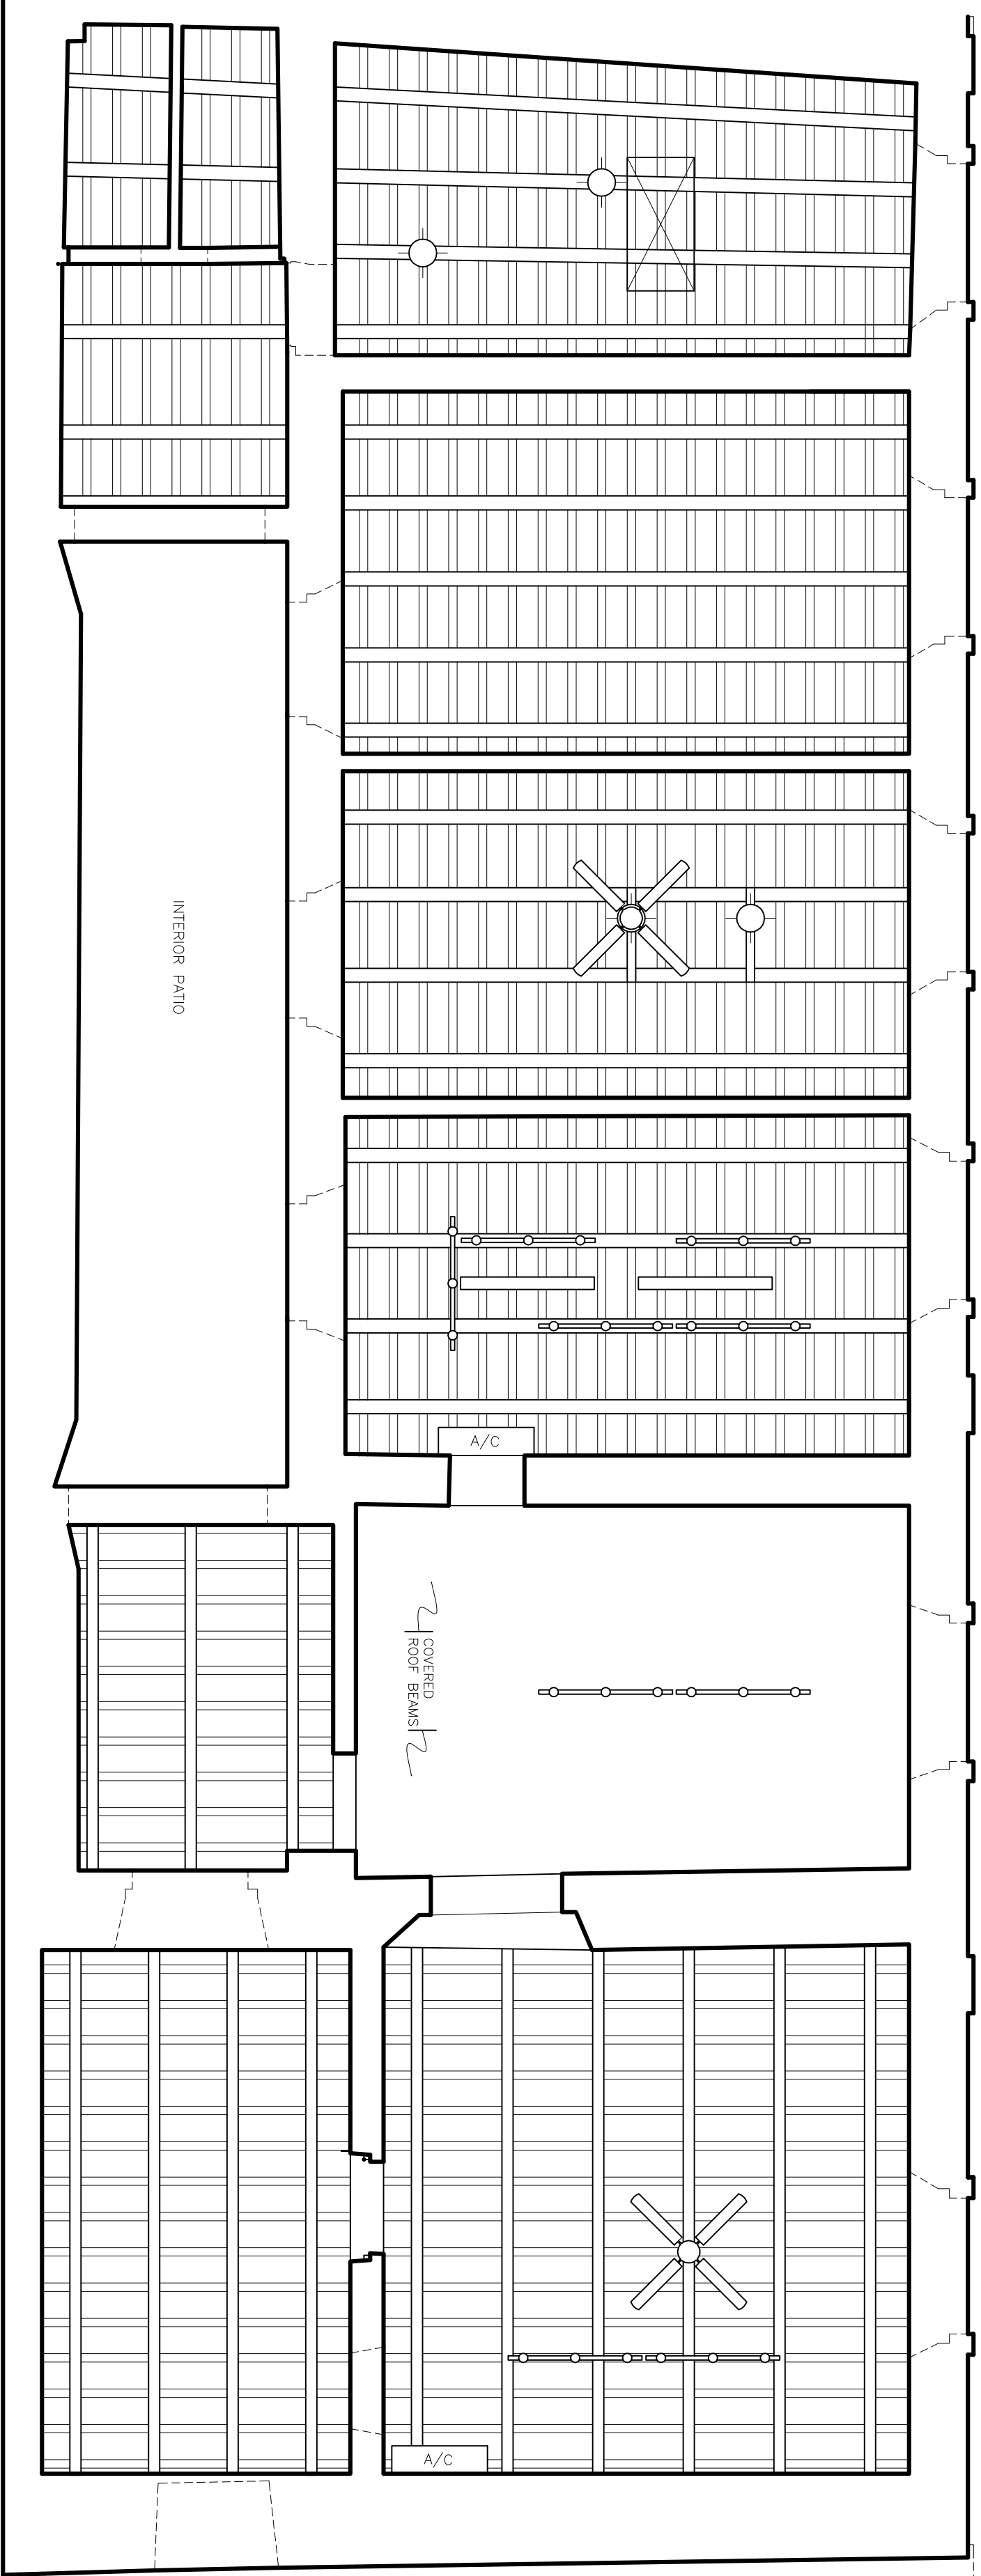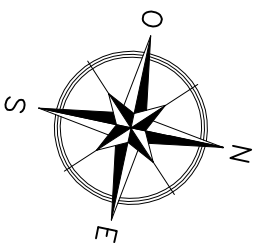

Lower Level Commercial Spaces Reflected Ceiling

Scale: 1/4"=1'-0"

OWNER:

Cheif Medawar

CONSULTANTS

Arch. Rodolfo Lugo Escamilla

(107) 960-1717 / rodolfo@rpe.com

PROJECT:

#200 Del Cristo St., Old San Juan
As Built Drawings

San Juan, P.R.

REVISIONS

NO.	DATE
1	
2	
3	
4	
5	


NOTES / PERMITS

DATE: October 24, 2015

Roof Plan
(As Built)



HOTAS:

AB-3

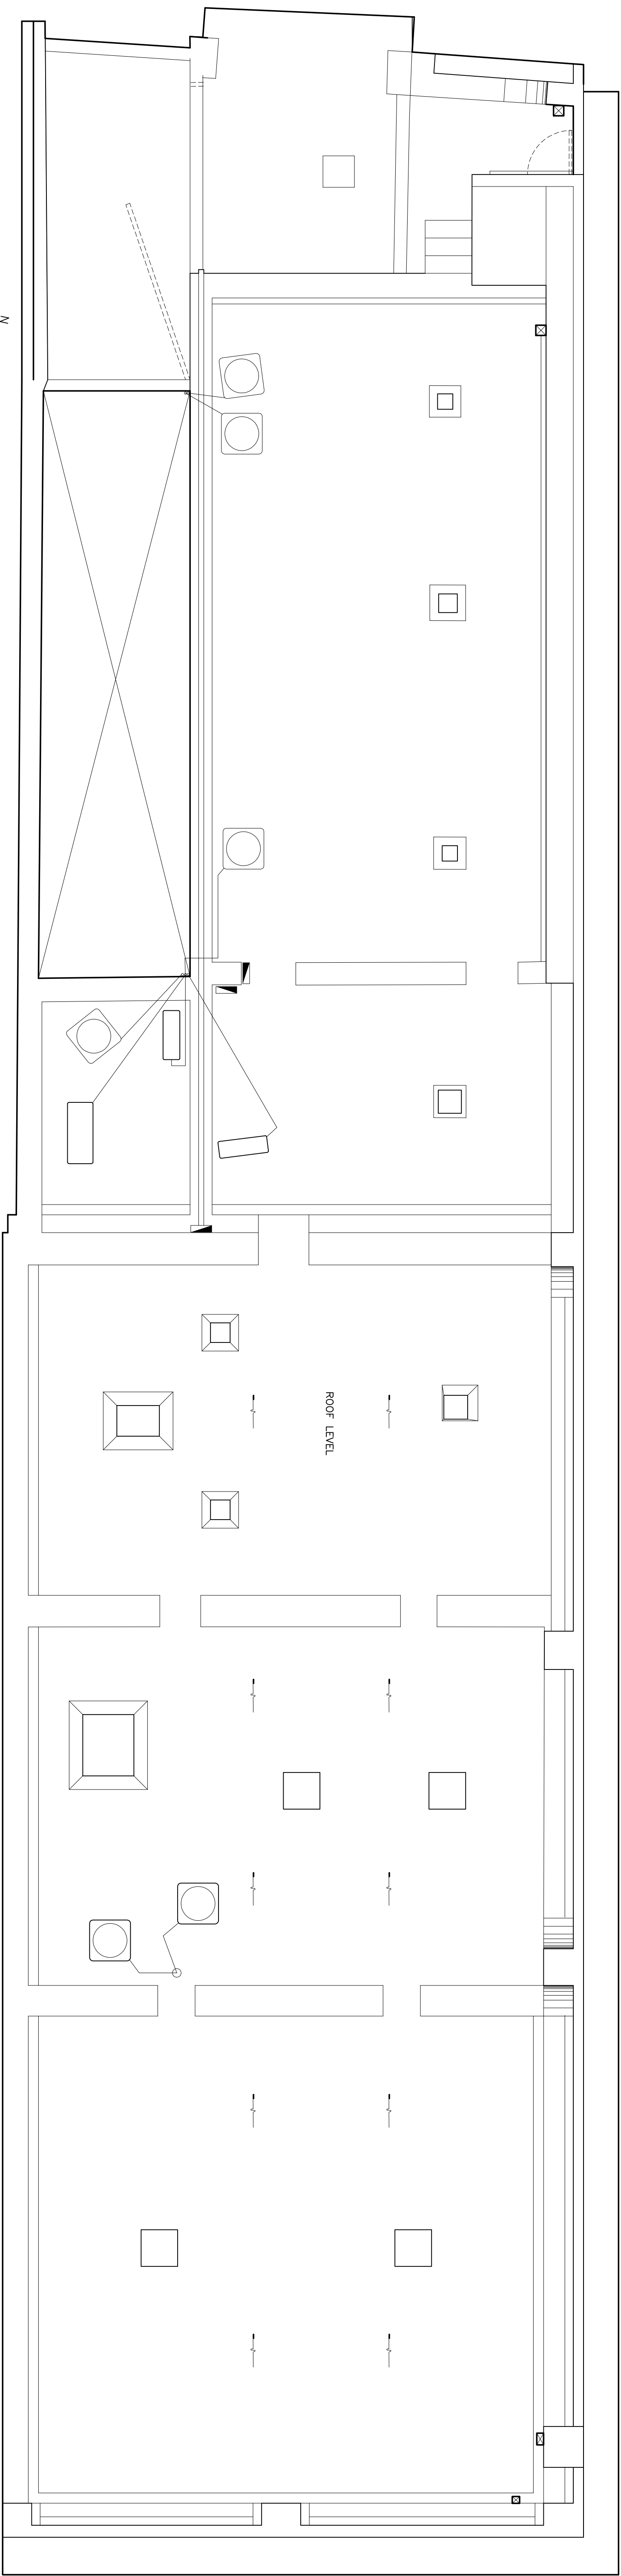

Roof Plan

Scale: 1/4"=1'-0"

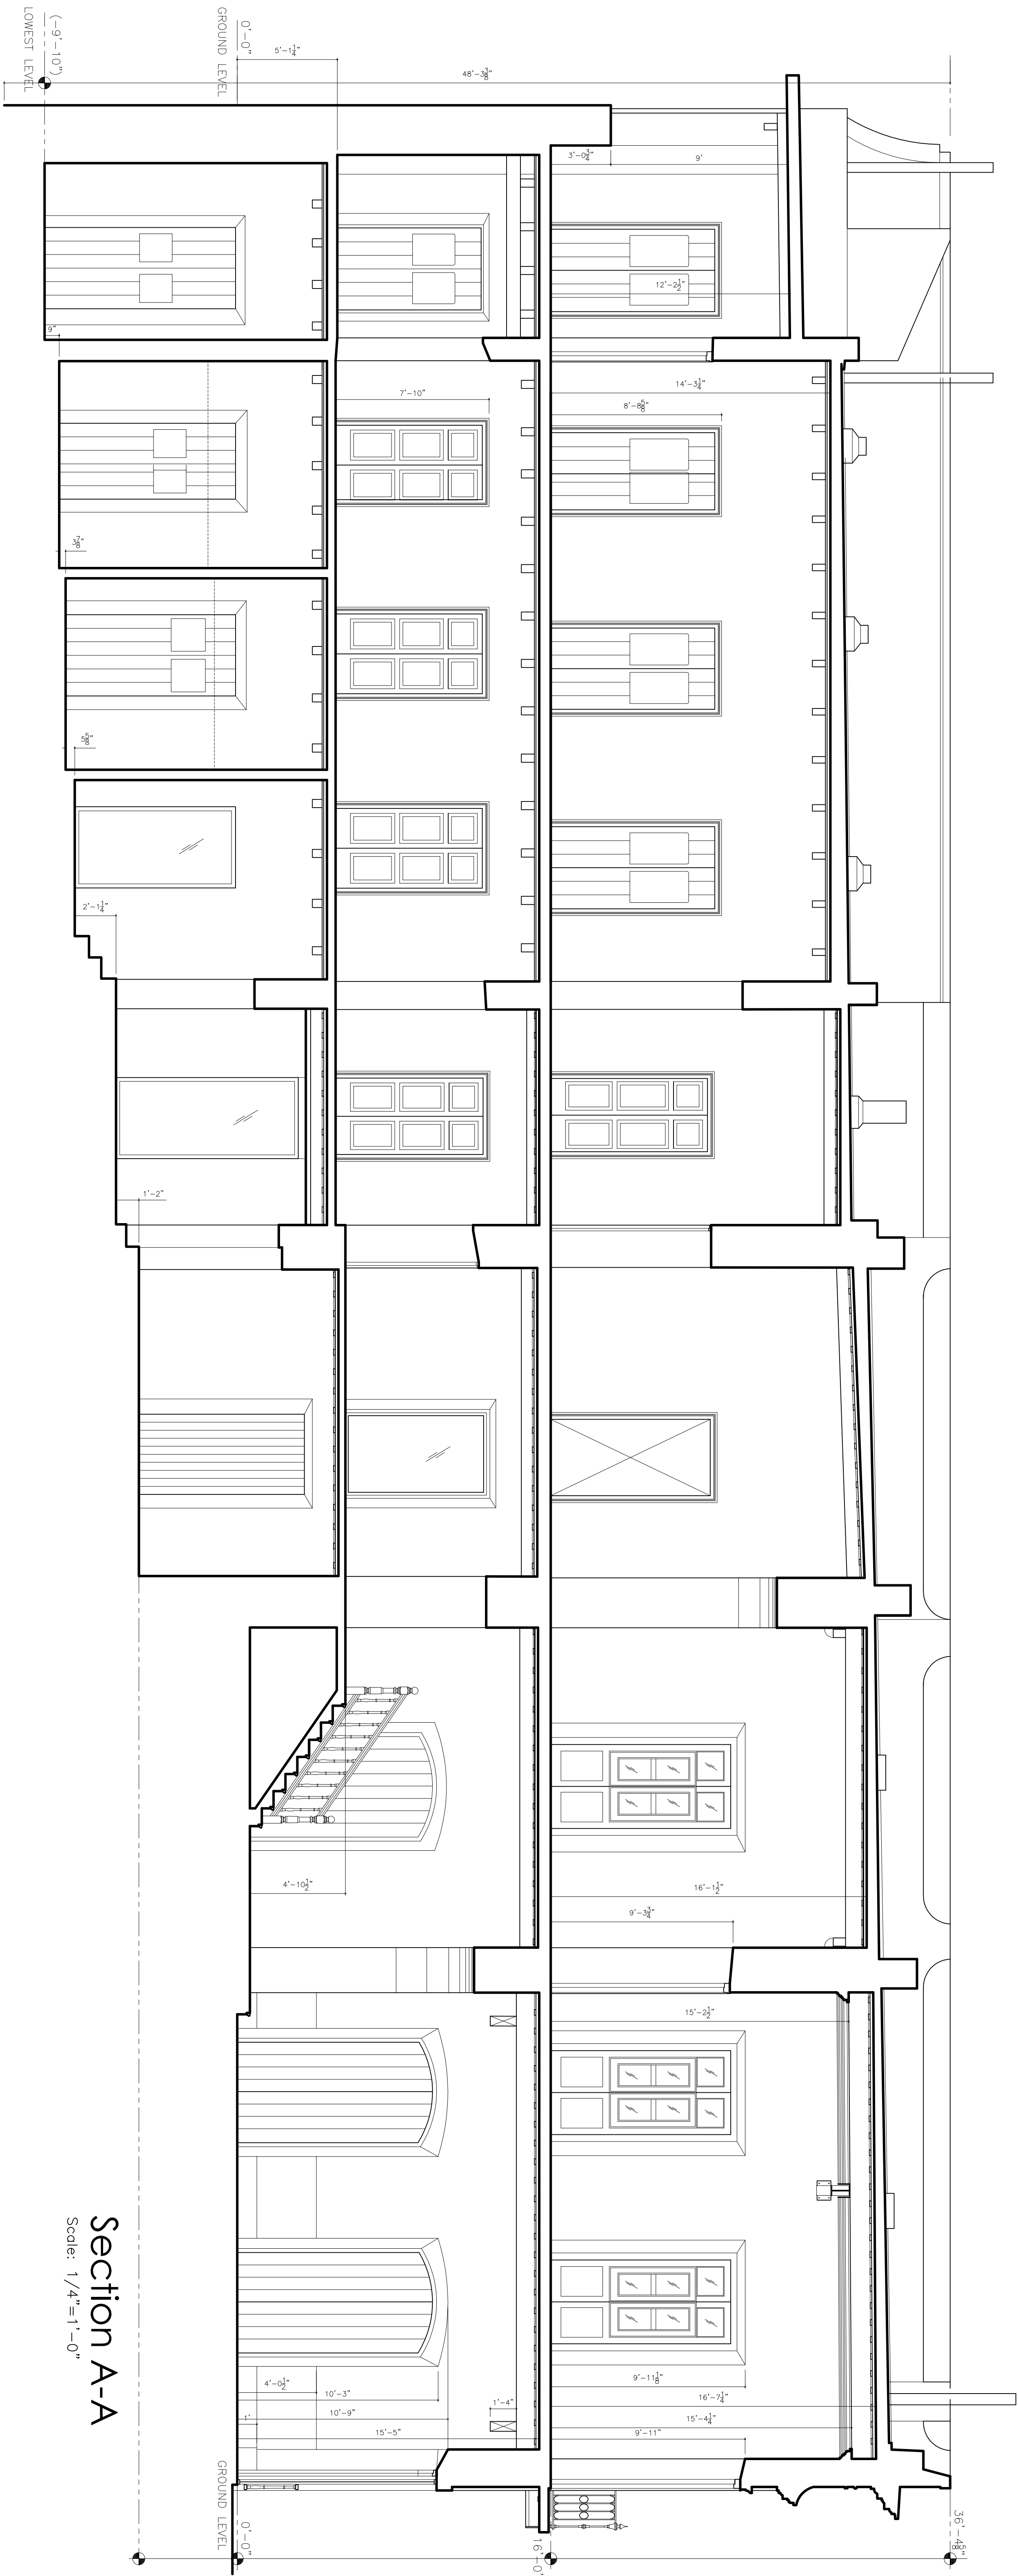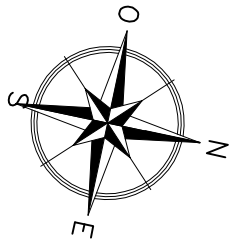

Section A-A

Scale: 1/4"=1'-0"

OWNER:

Cheiff Medawar

CONSULTANTS

Arch. Rodenas Lugo Screenfield

(info@rodensaslugoscreenfield.com)

PROJECT:

#200 Del Cristo St., Old San Juan
As Built Drawings

San Juan, P.R.

REVISIONS

NO.	DATE
1	
2	
3	
4	
5	

NOTES / PERMITS


DATE: October 24, 2015

Roof Plan
and Section

(As Built)


HOUA:

AB-4

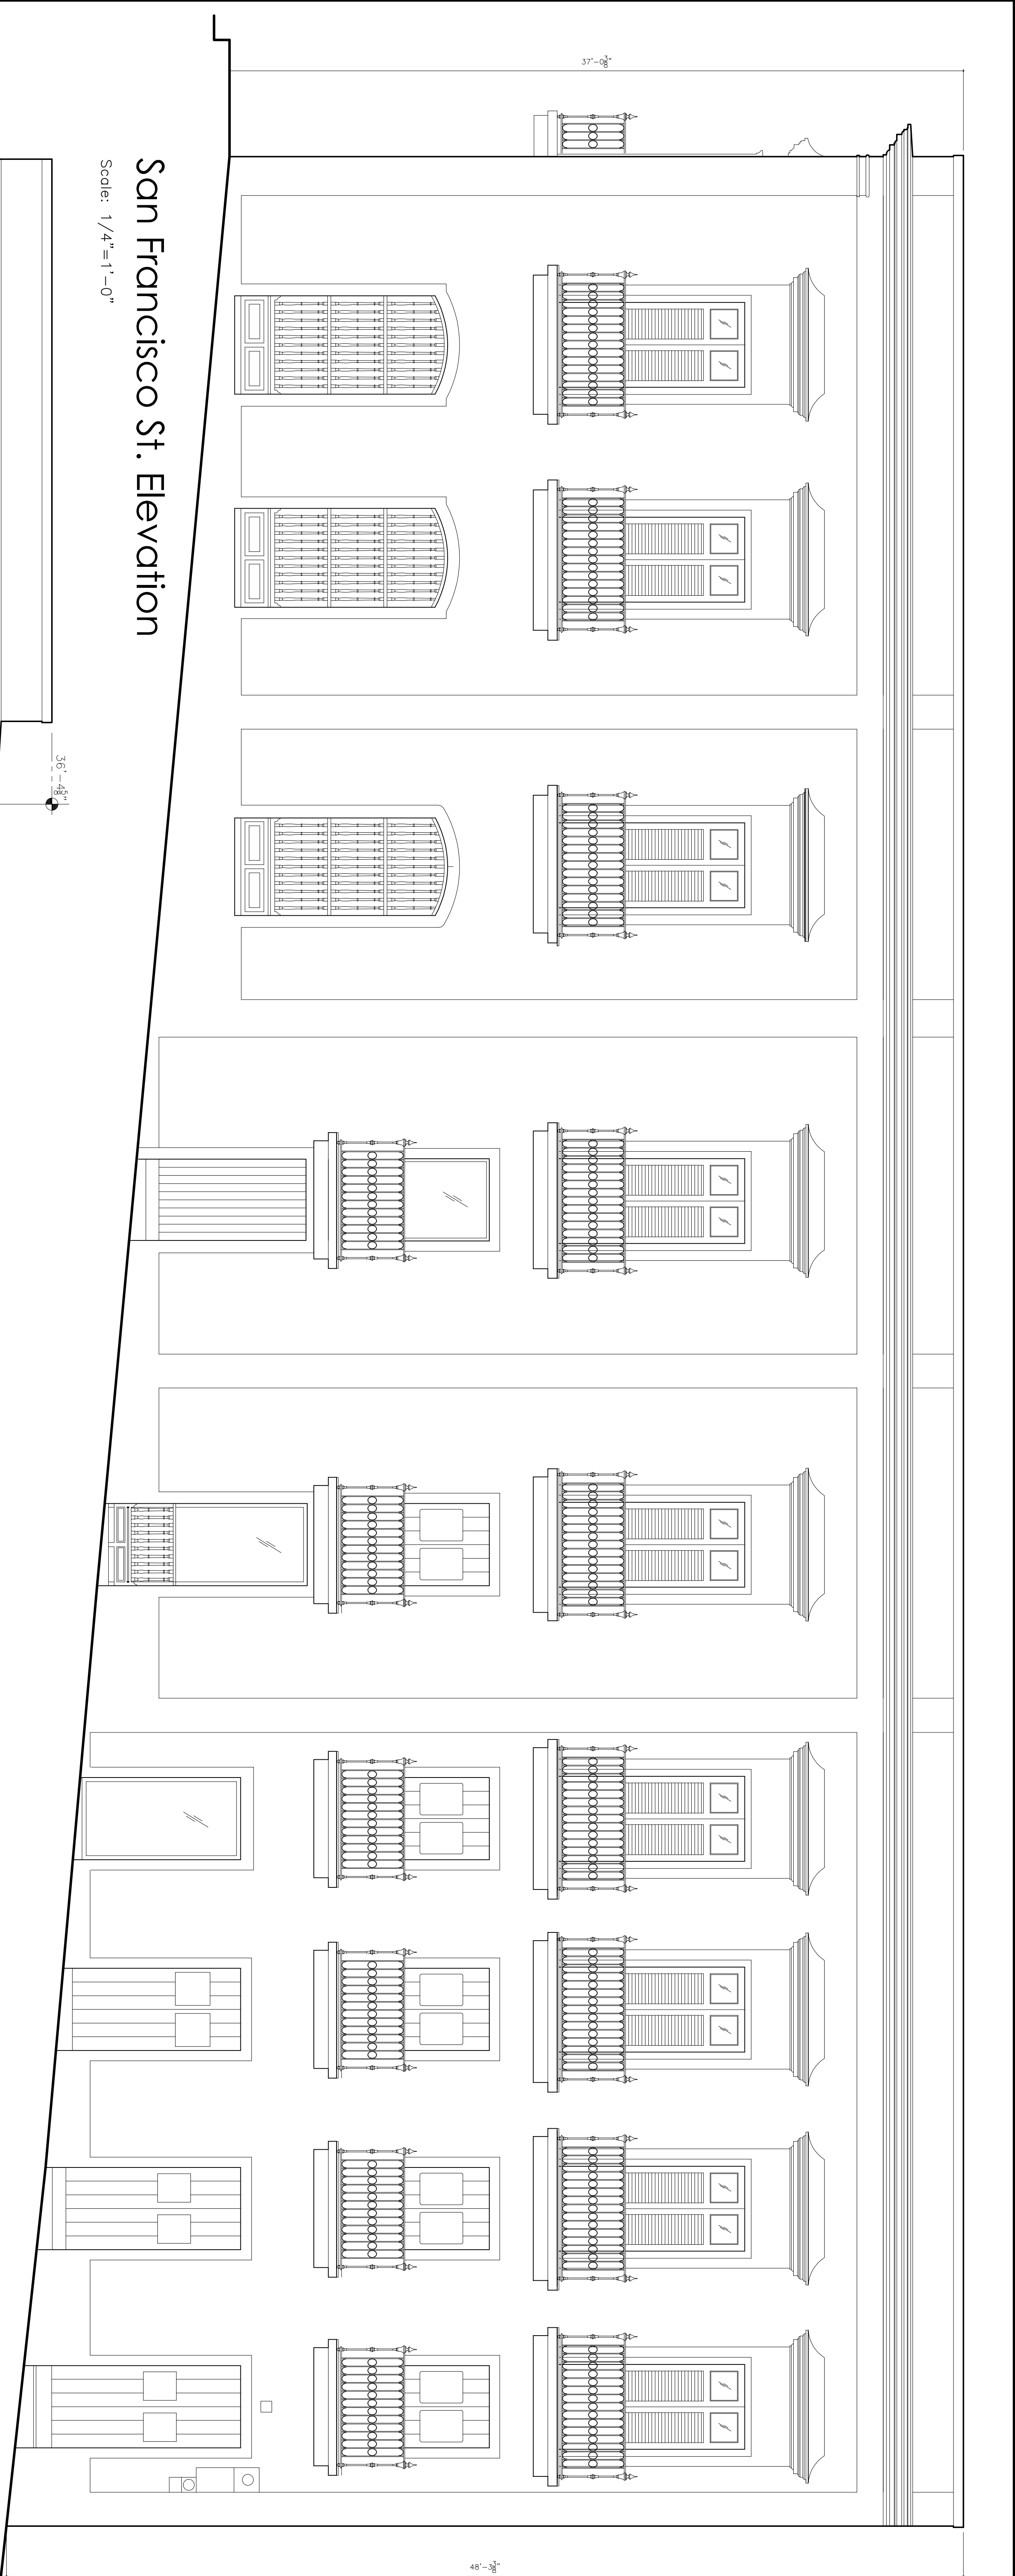

San Francisco St. Elevation

Scale: 1/4"=1'-0"

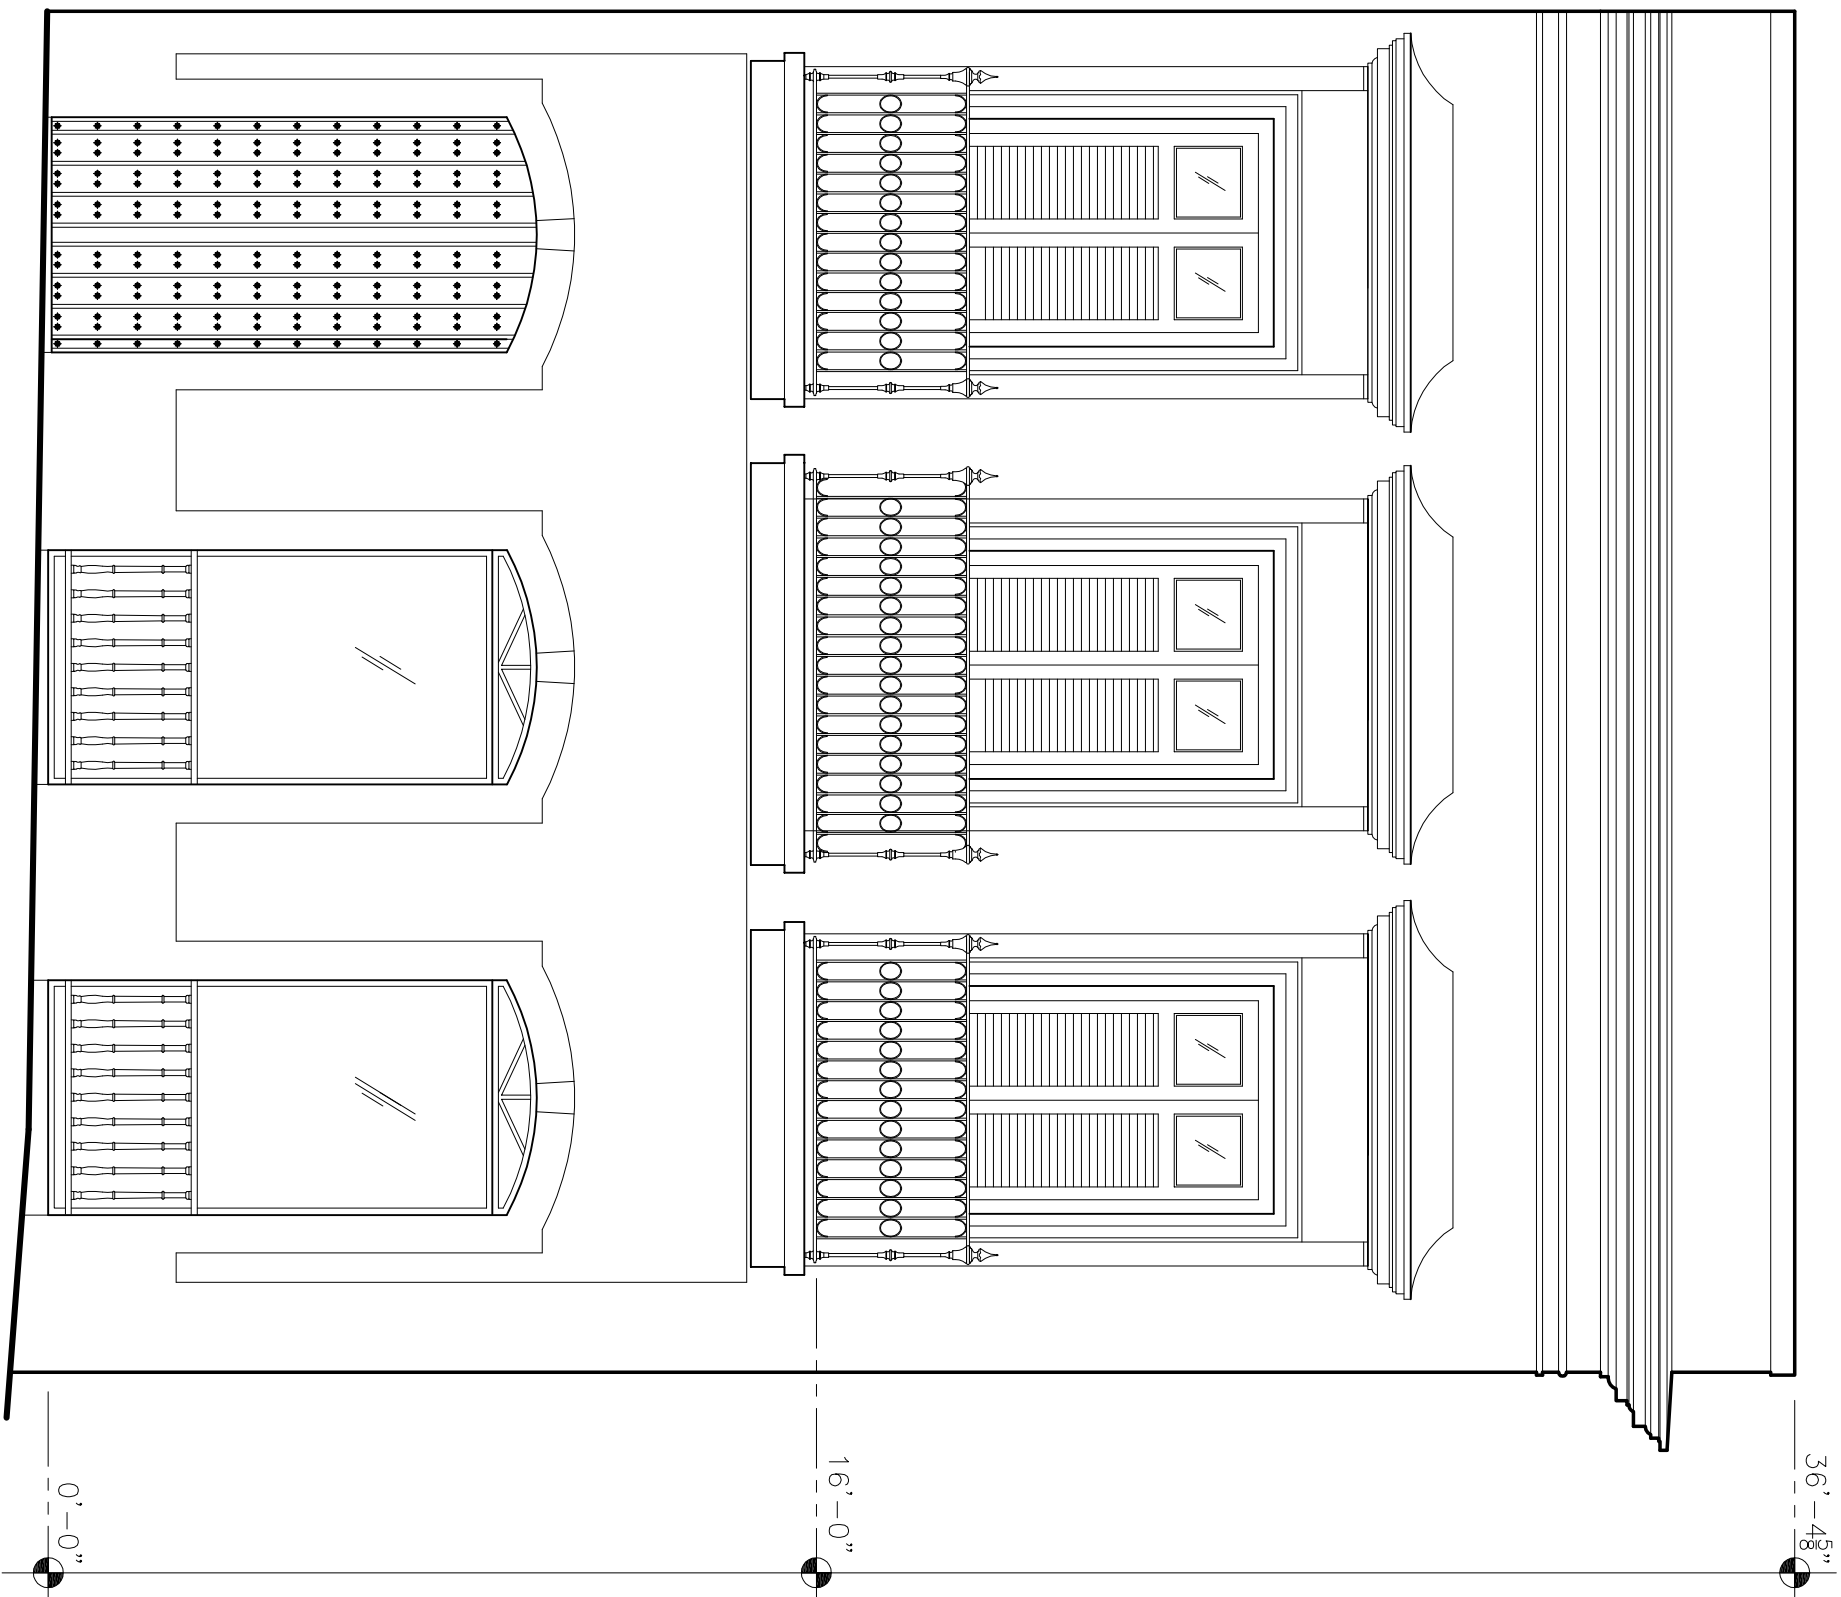

San Francisco St. Elevation

Scale: 1/4"=1'-0"

OWNER:

Cheif Medawar

CONSULTANTS

Art Rodenas Lugo SCENEMOLD

(609) 302-1717 / arod@scenemold.com

PROJECT:

#200 Del Cristo St., Old San Juan
As Built Drawings

San Juan, P.R.

REVISIONS

NO.	DATE
1	
2	
3	
4	
5	


NOTES / PERMITS

DATE: October 24, 2015


Elevations
(As Built)

HOTAS:


AB-5

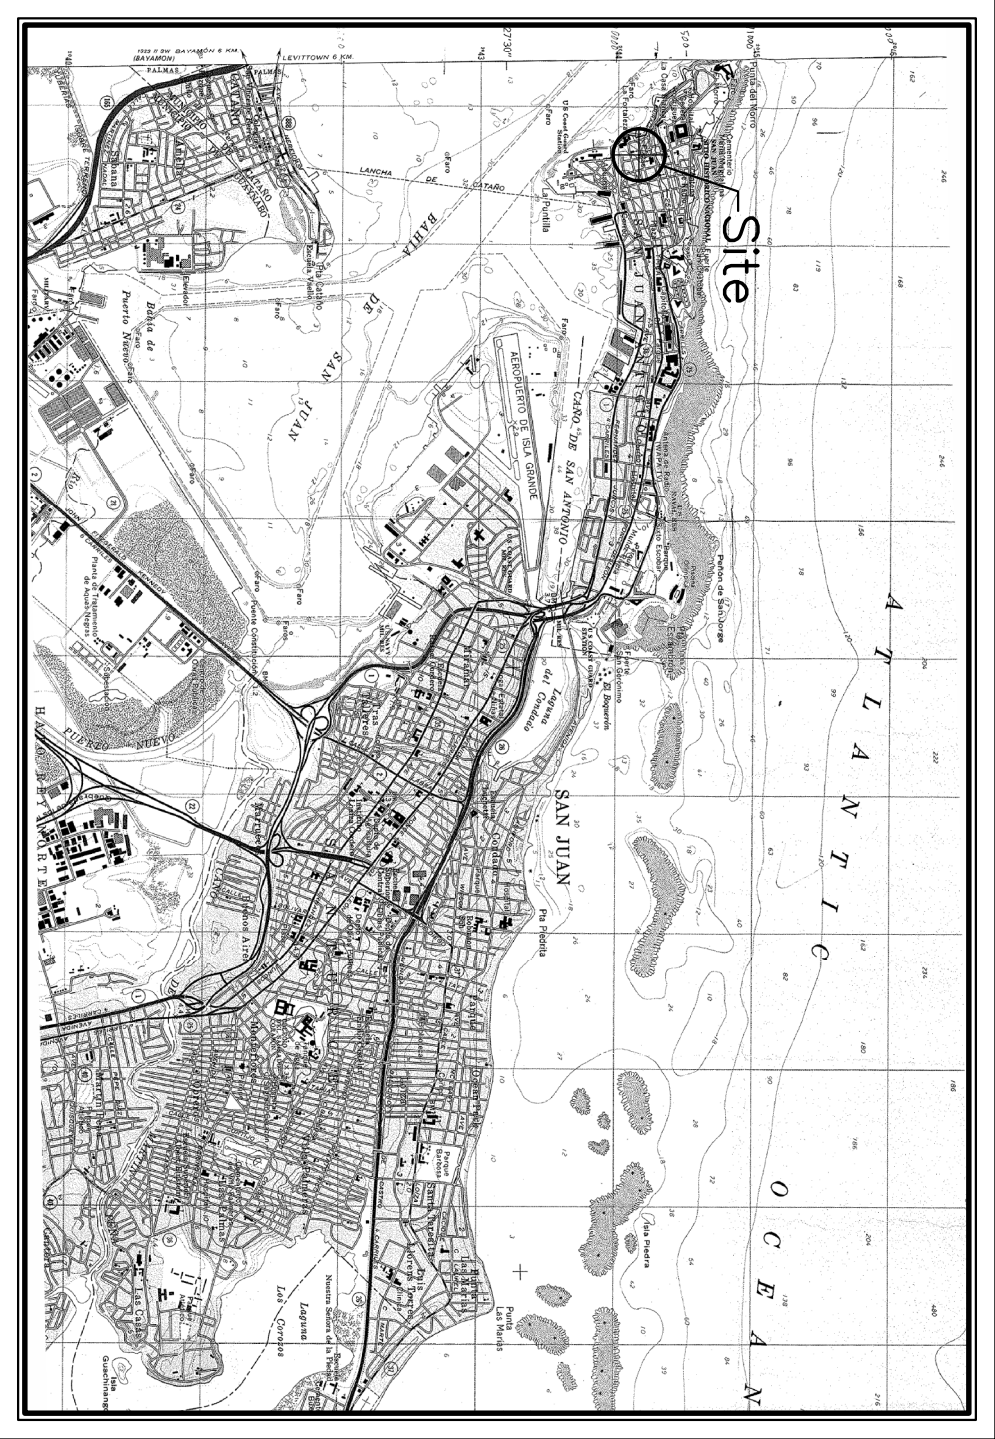


USGS Quadangle Map

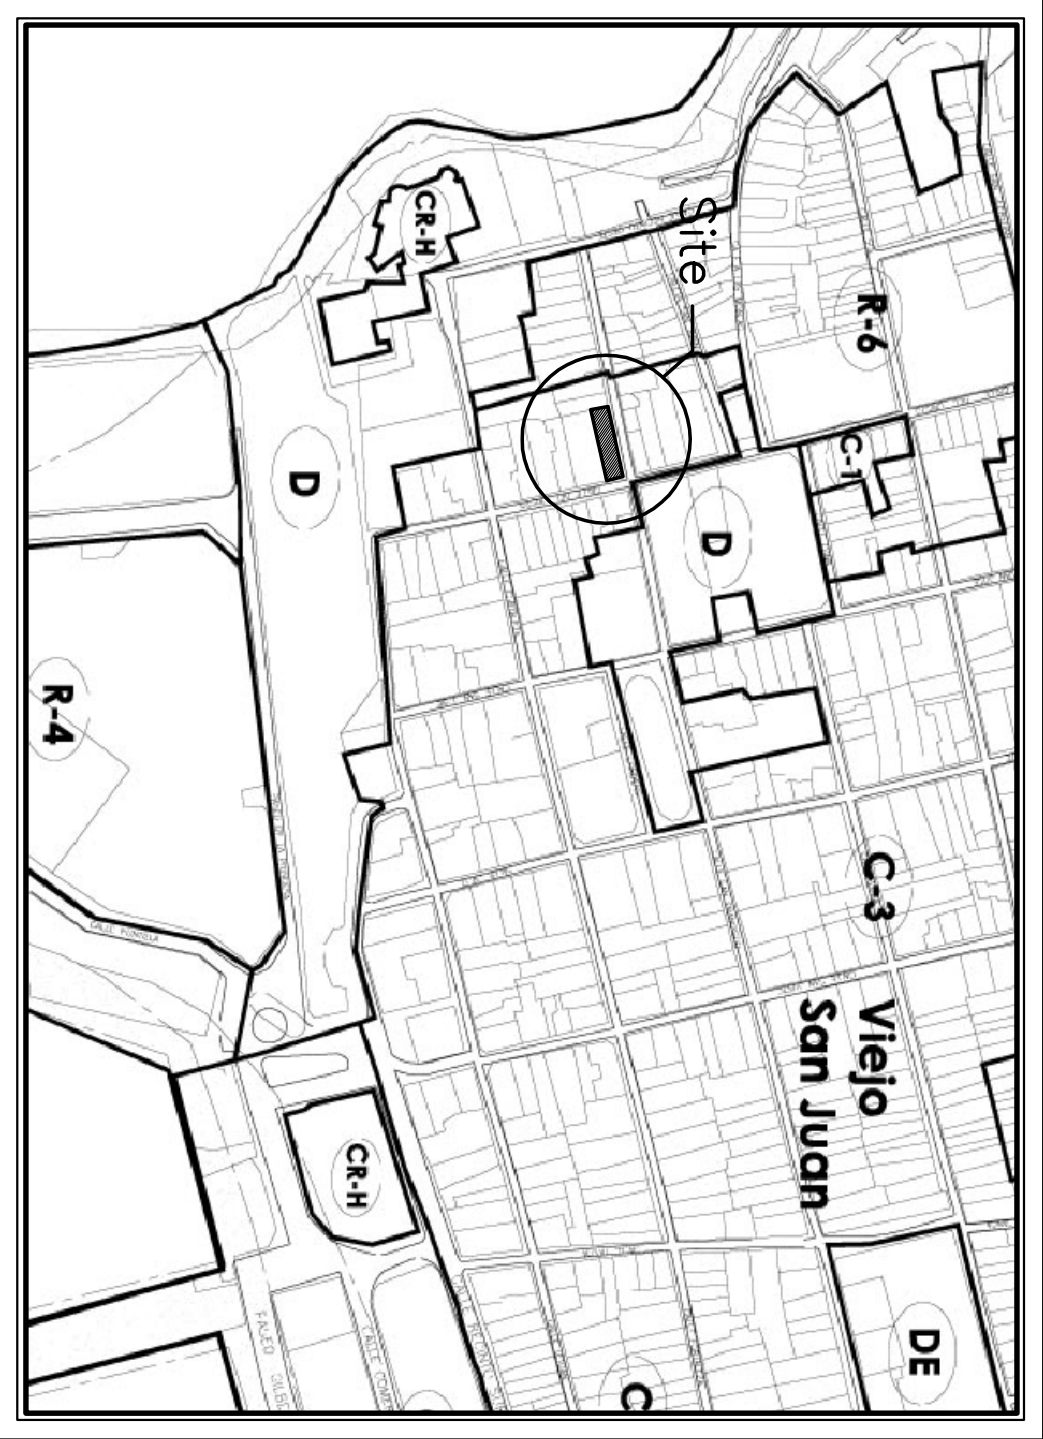

Zoning Map (Sheet 3D and 3E / August 4, 2013 and March 2, 2014)

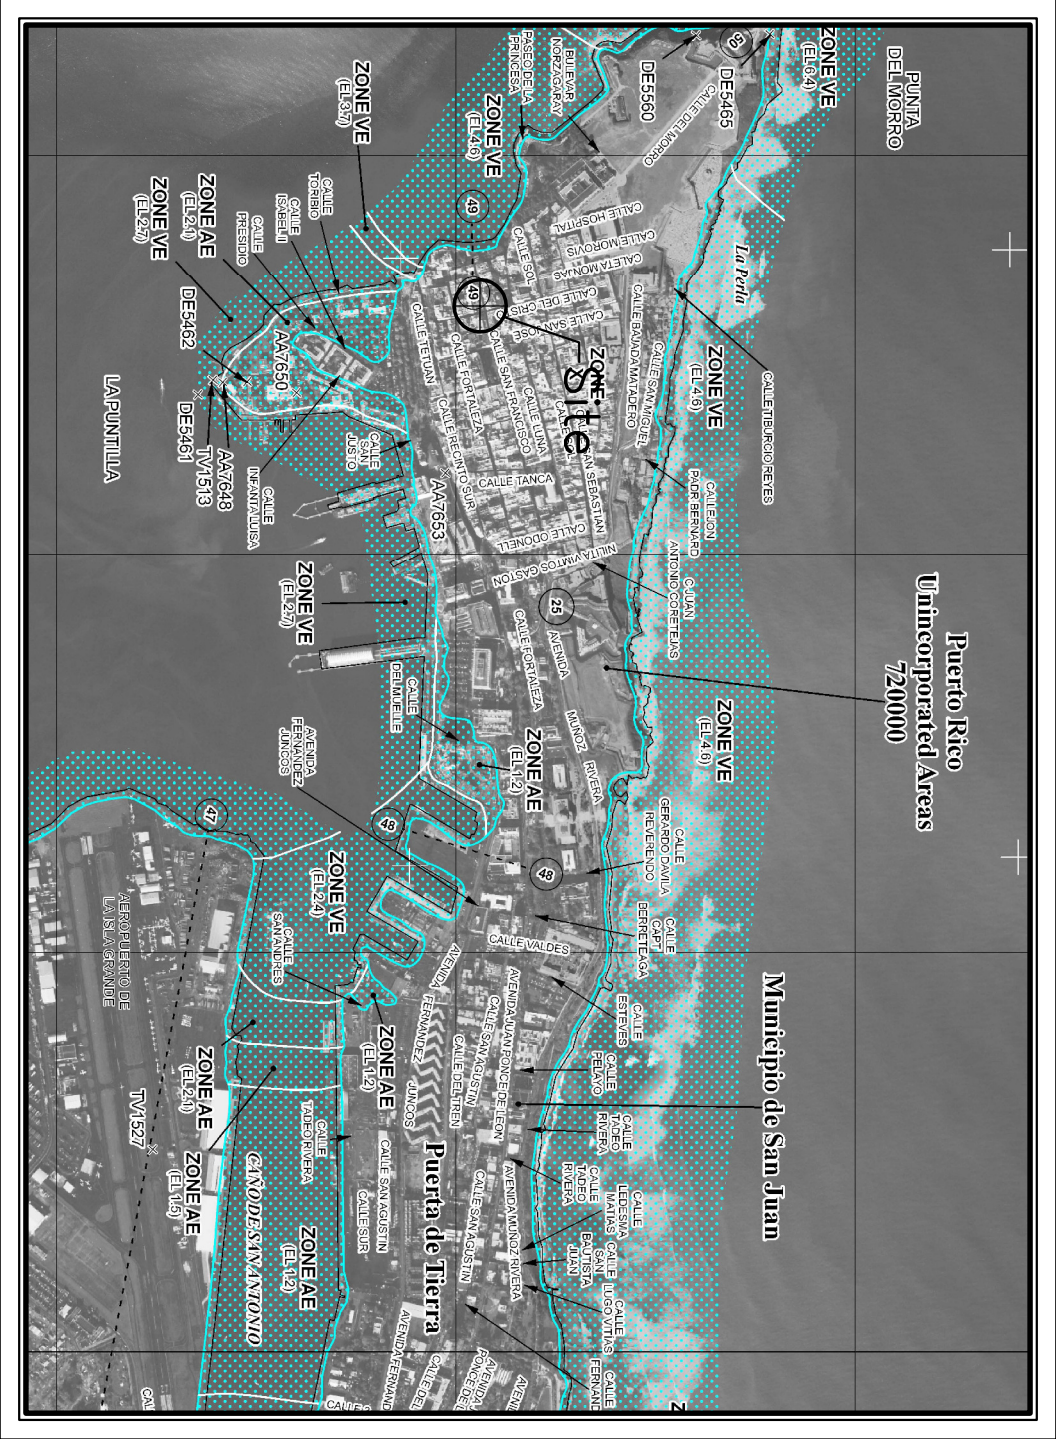

Flood Map (C00070355J) November, 18, 2009

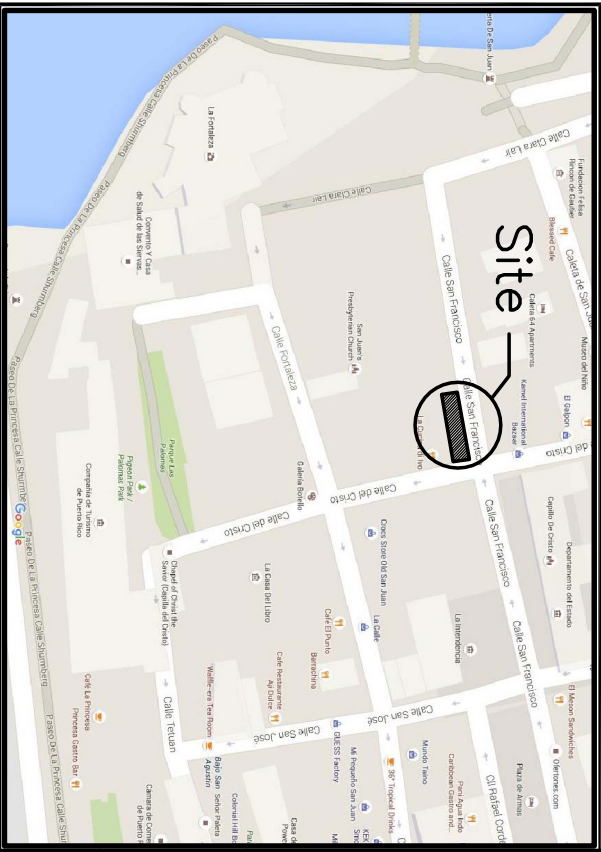

Map of Puerto Rico

#200 Del Cristo St.
Old San Juan, P.R.

Location

Catastro 040-002-042-09

No.	Title
HT-1	First Sheet
AB-1	FIRST LEVEL FLOOR PLAN
AB-2	SECOND LEVEL FLOOR PLAN
AB-3	LOWER LEVEL COMMERCIAL SPACES FLOOR PLAN
AB-4	ROOF PLAN AND SECTION A-A ELEVATIONS
AB-5	


#200 Del Cristo St., Old San Juan

As Built Drawings

San Juan, P.R.

Del Cristo St. Elevation

Scale: $\frac{1}{8}$ "=1'-0"

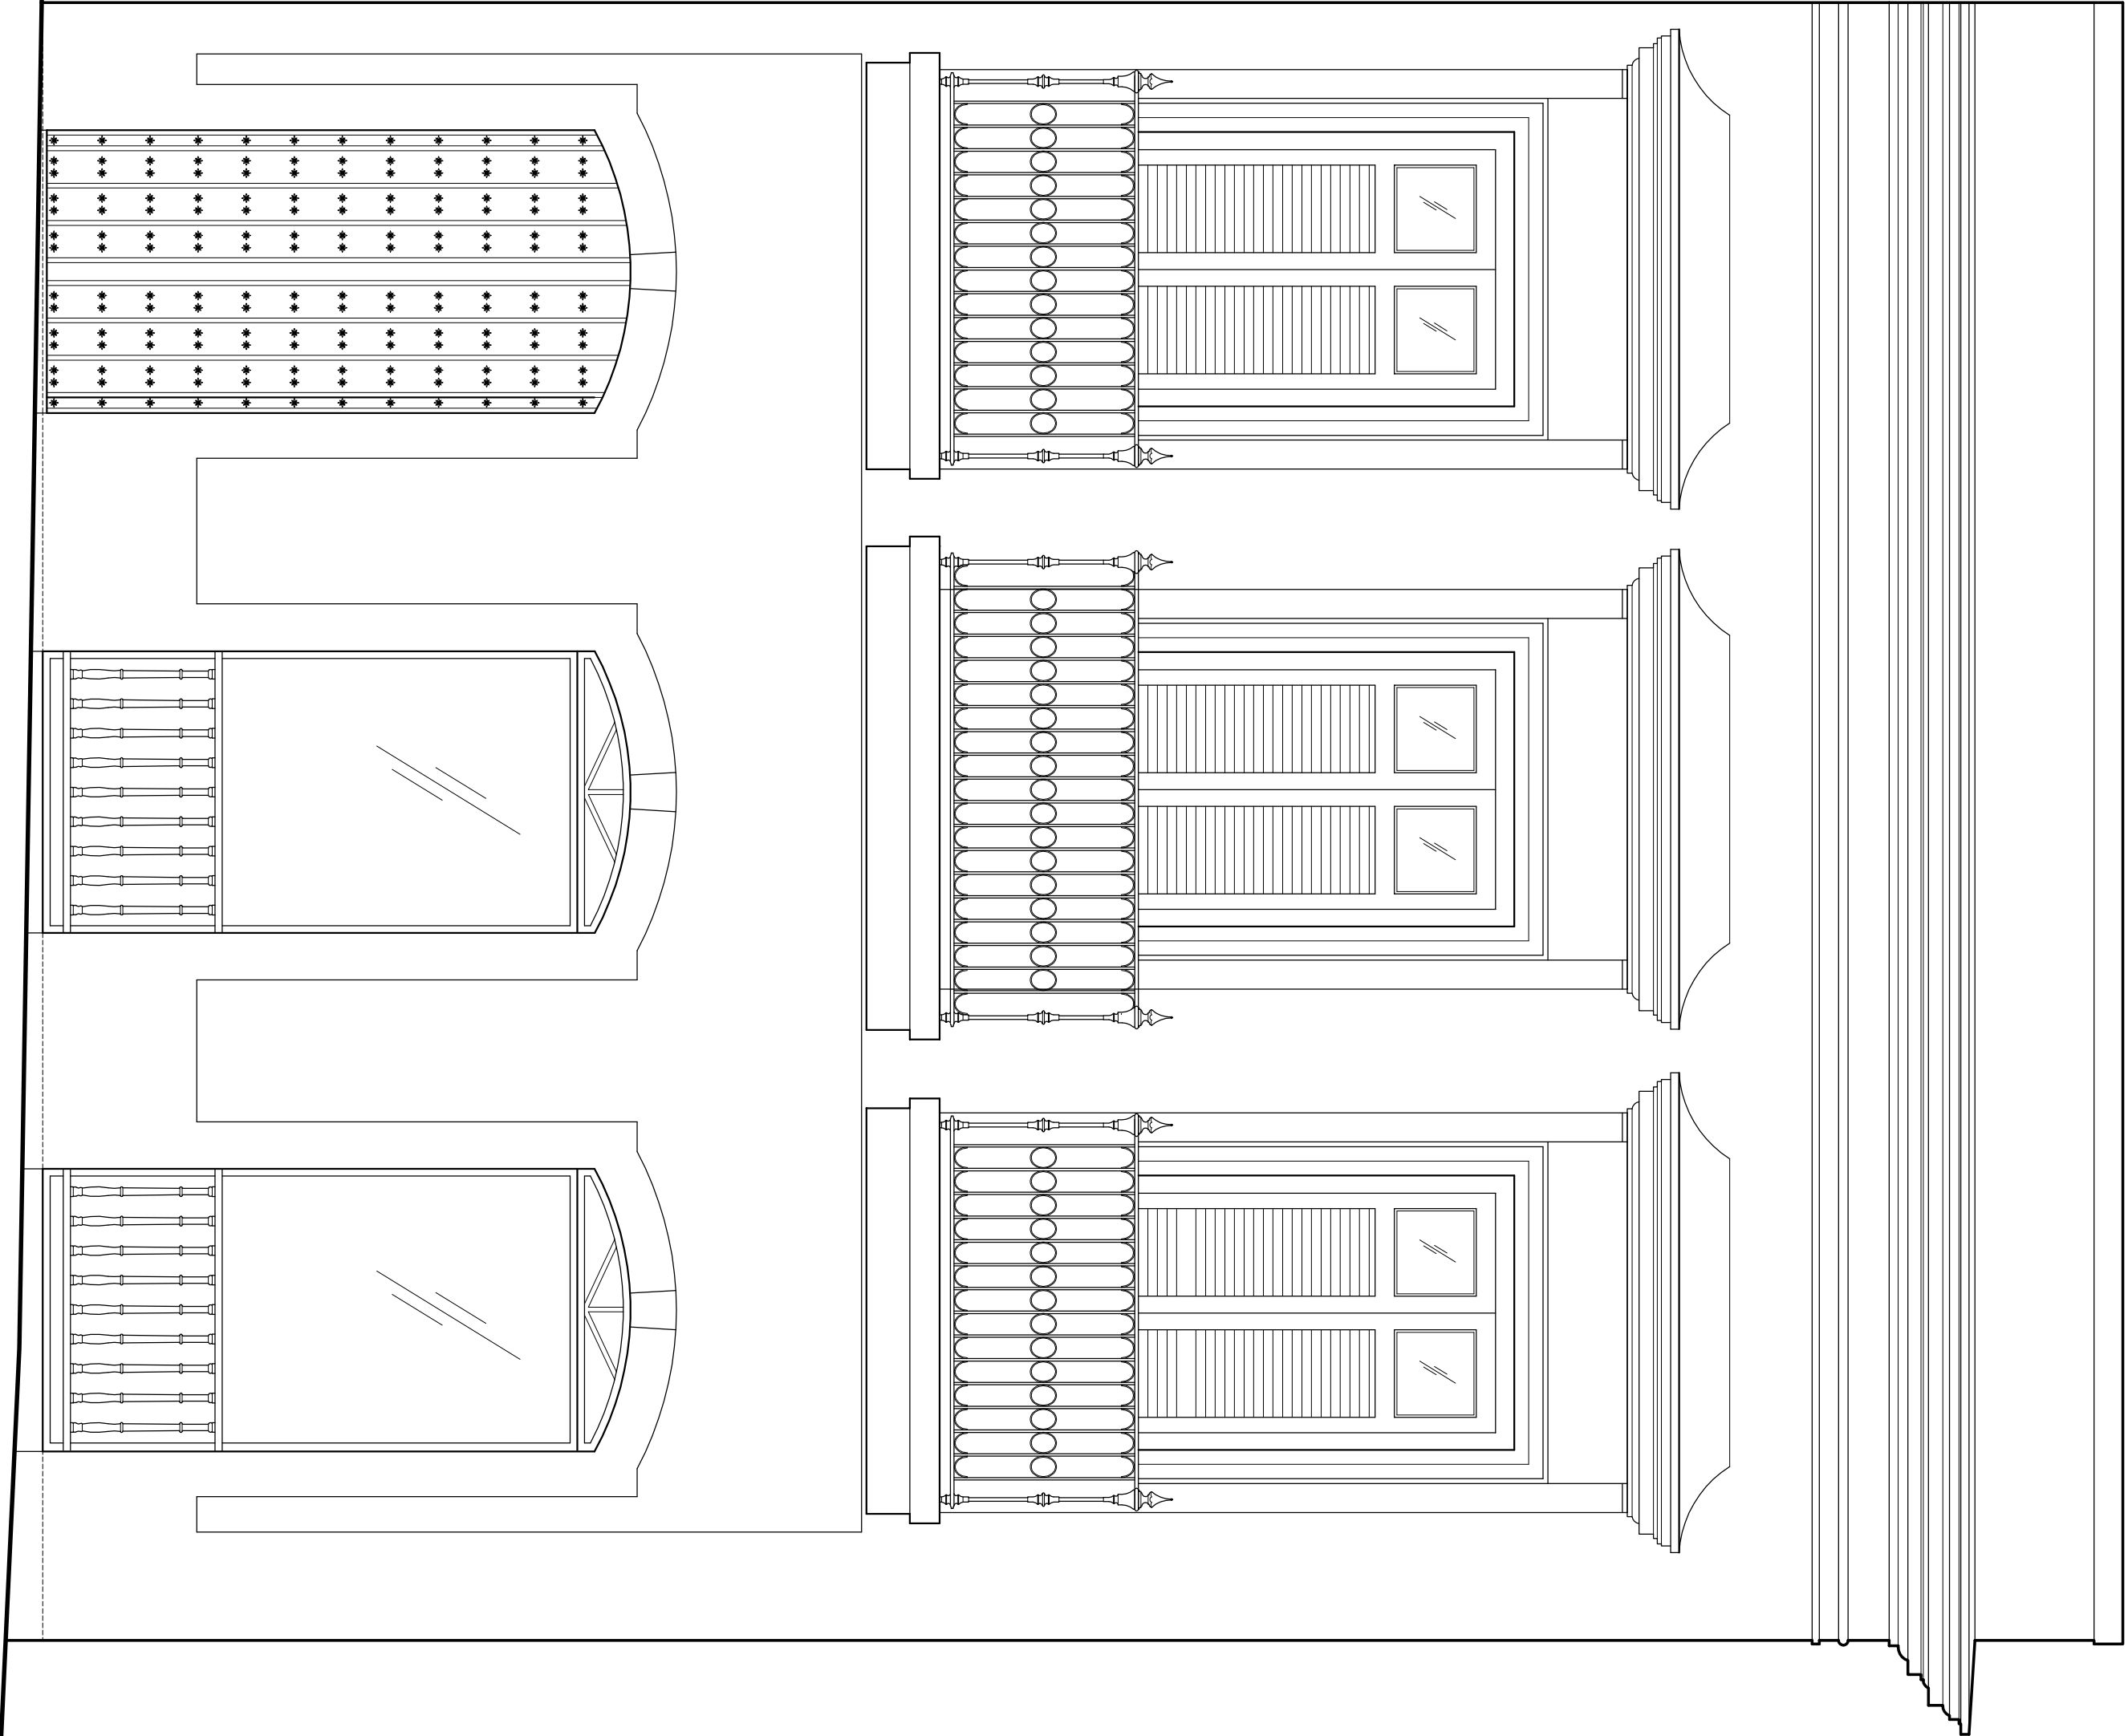

OWNER:

Cheiff Medawar

CONSULTANTS

Art. Rodenas Logo Screenwall
(10/10/2017) / 10/10/2017 / 10/10/2017

PROJECT:

#200 Del Cristo St., Old San Juan

As Built Drawings

San Juan, P.R.

REVISIONS

NO.	DATE
1	
2	
3	
4	
5	

NOTES / PERMITS

DATE: October 24, 2015

Title Sheet

HOTAS:

HT-1